



Work Area within Battery Casemate:

Casemate interior - 52 feet wide by 32 feet deep by 14 feet high.

Casemate canopy (shown as dotted semi-circular line) projects approximately 15 feet from casemate walls and is 18 feet above finished floor.

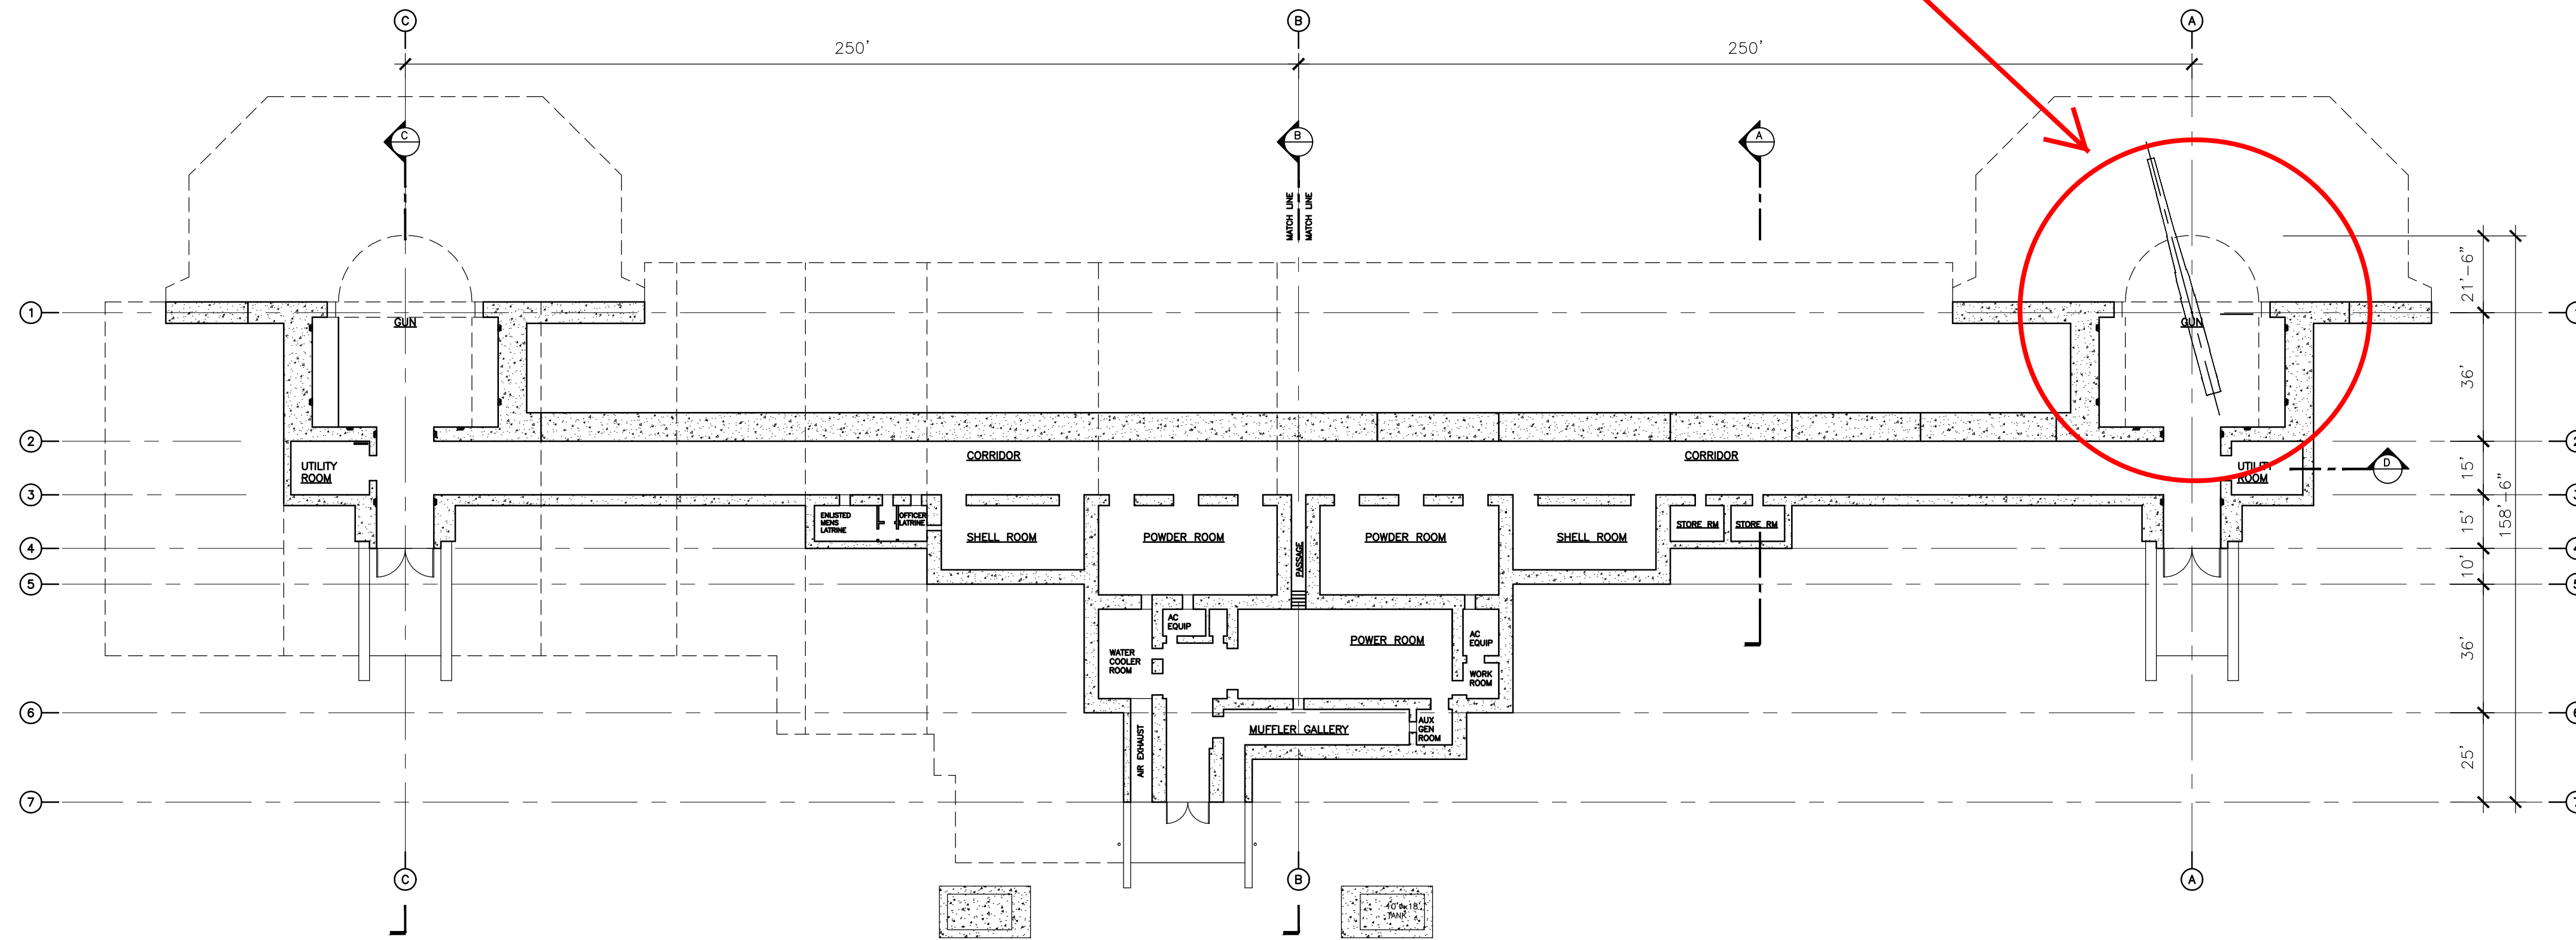

PLAN
0 4 8 16 24 32'

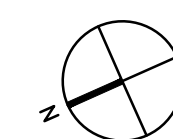

NOTES:
1. ALL DRAWINGS BASED ON 1942 CORP OF ENGINEERS PLANS AND MINOR FIELD VERIFICATION 01/15/14.
2. GRIDLINES ADDED TO DRAWINGS FOR CLARITY.

REV DATE BY

THESE DRAWINGS, SPECIFICATIONS AND DESIGNS ARE THE PROPERTY OF THE MONMOUTH COUNTY PARK SYSTEM (MCPS). NO PART THEREOF SHALL BE COPIED OR USED WITH ANY OTHER PROJECT FOR WHICH THEY HAVE BEEN DEVELOPED. WITHOUT THE WRITTEN CONSENT OF MCPS, MCPS MAKES NO WARRANTY AND ALL RESPONSIBILITY AND LIABILITY FOR PROBLEMS WHICH ARISE FROM FAILURE TO FOLLOW THESE PLANS, SPECIFICATIONS AND DESIGN INTENT IS THE PROPERTY OF MCPS. NO PART THEREOF SHALL BE COPIED OR USED WITH ANY OTHER PROJECT FOR WHICH THEY HAVE BEEN DEVELOPED. WITHOUT THE WRITTEN CONSENT OF MCPS, MCPS MAKES NO WARRANTY AND ALL RESPONSIBILITY AND LIABILITY FOR PROBLEMS WHICH ARISE FROM FAILURE TO FOLLOW THESE PLANS, SPECIFICATIONS AND DESIGN INTENT IS THE PROPERTY OF MCPS.

MONMOUTH COUNTY PARK SYSTEM
BOARD OF PARK AND RECREATION COMMISSIONERS
805 NEWMAN SPRINGS ROAD
MICRODOT, NJ 07738-1865
PHONE (732) 842-4000 FAX (732) 842-3640



BATTERY LEWIS AS BUILT
HARTSHORNE WOODS PARK 417
PLAN

DATE 12/12/12 SCALE AS NOTED PROJECT # DRAWN GAC CHECKED GAC

SHEET NO. 1
OF 5