
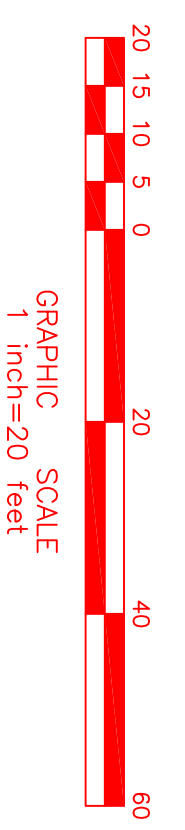


NOTES:
 ELEVATIONS REFER TO PLAN GRADES
 parking and Cross walk striping
 was taken from approved site plan.
 Any Object beneath the surface of the
 Ground has not been located, and no
 Guarantee as to existence or location
 is expressed or implied.
 THIS SURVEY HAS BEEN PREPARED WITHOUT A
 FULL TITLE SEARCH AND IS SUBJECT TO SUCH
 FACTS THAT MIGHT BE REVEALED BY SMD
 TITLE SEARCH.

- LEGEND:
- x 8.37 = SPOT ELEVATION
 - = SAN. CLEAN OUT
 - ⊙ = SAN. MAN HOLE
 - ⊕ = UTILITY POLE
 - ⊙ = SOLAR LIGHT
 - ⊙ = PARKING SPACES
 - 6.6% = RAMP SLOPE
 - ⊕ = WOOD PILING

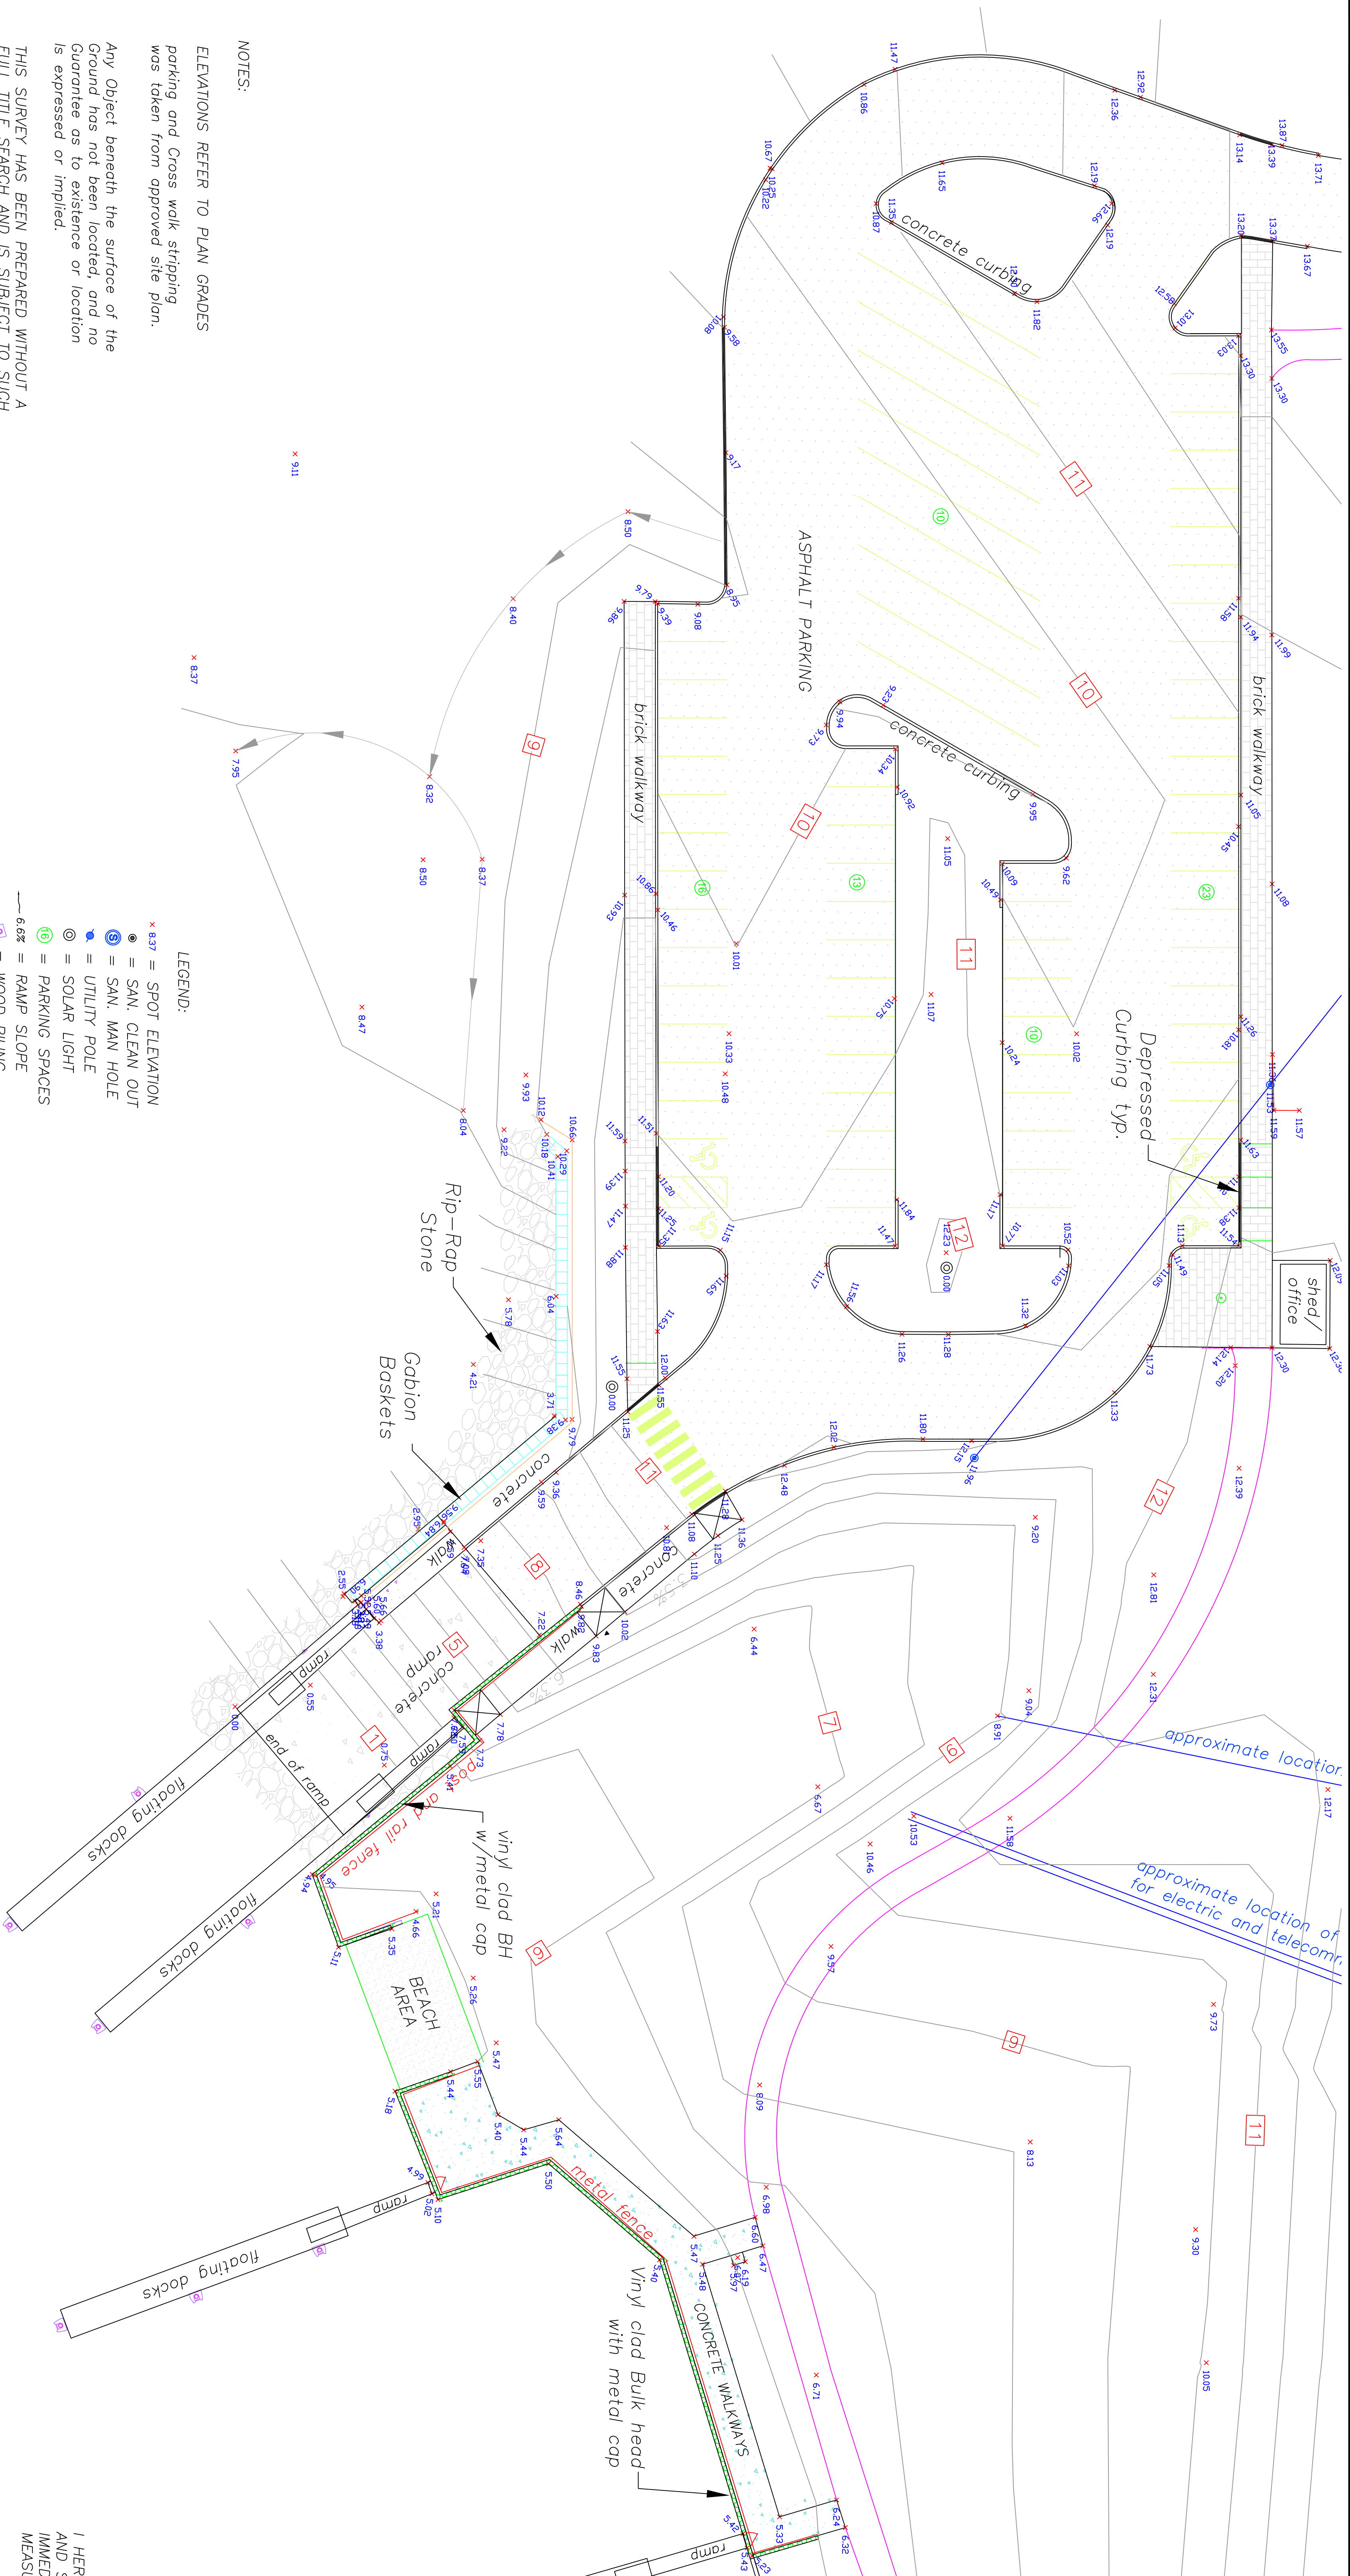

RONALD
 PROFILE
 N.Y. - E.I.

I HEREBY
 AND S
 IMMEDI
 MEASU

PROPOSED SITE PLAN #2

MONMOUTH COUNTY PARK SYSTEM
 SWIMMING RIVER PARK

SITUATION:
 MIDDLETOWN TOWNSHIP, MONMOUTH COUNTY, NEW JERSEY

P. RECISE
CONSTRUCTION
INCORPORATED

1000 Highway 35 - Freehold, NJ 07723
 TEL: (732) 463-1166 FAX: (732) 463-1175

Job Name: SWIMMING RIVER PARK Date: 2023-06-20 Scale: 1/10" = 1'-0" Plot No: 2 of 6